



NOTES

1. Geometrics shall be confirmed prior to the installation of signal equipment. All traffic signal foundations shall be installed at final sidewalk or curb grade for closed sections, highest roadway profile grade for open sections to meet clearances as specified in MD 816.03, MD 818.01, MD 818.02, MD 818.04. The contractor shall verify ultimate grades prior to the installation of all signal equipment.
2. Loop detectors and conduits shall be installed prior to the installation of pavement markings.
3. All pavement markings will either be installed as part of the Developer's project or are to be considered as existing.
4. Revision 'F' is a revision to the traffic signal built in April, 1983 under S.H.A. Contract No.: WO-603-501-185.
5. All underground and overhead utilities shown on these plans are schematic and are not to be considered complete. The Contractor shall be responsible for notifying all utility companies prior to construction so that all utilities may be located in the field. If the Contractor perceives that a conflict between the utilities and the traffic signal equipment will occur, the Contractor shall notify the appropriate Project Engineer immediately.


EXISTING SIGNS

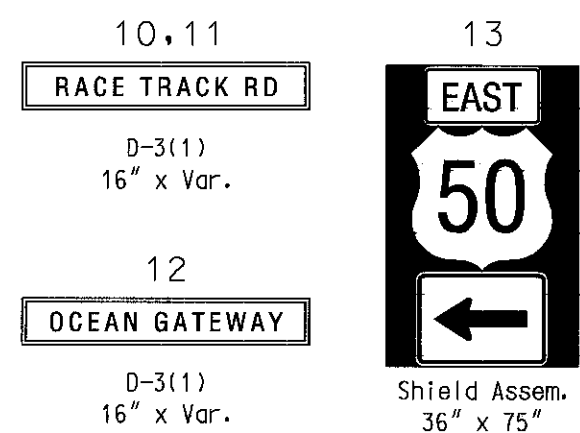


EXISTING SIGNALS

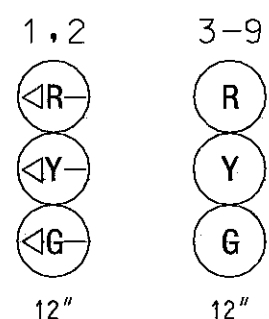

EXISTING NEMA PHASING

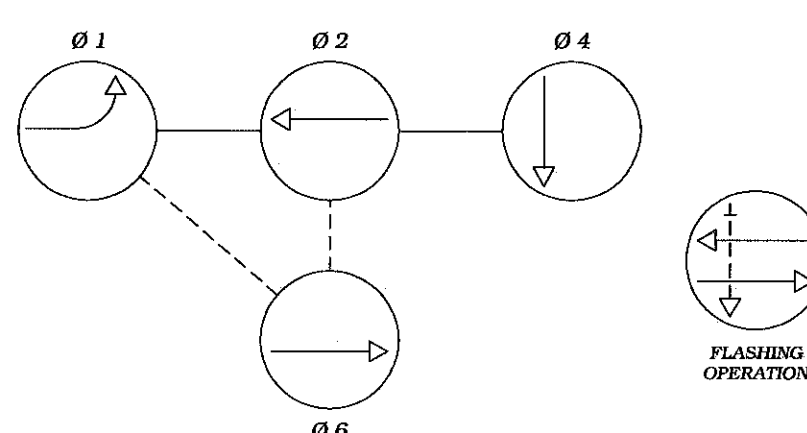

NEMA notes:
Phases associated by a dashed line will operate concurrently.
Phases associated by a solid line will not operate concurrently.

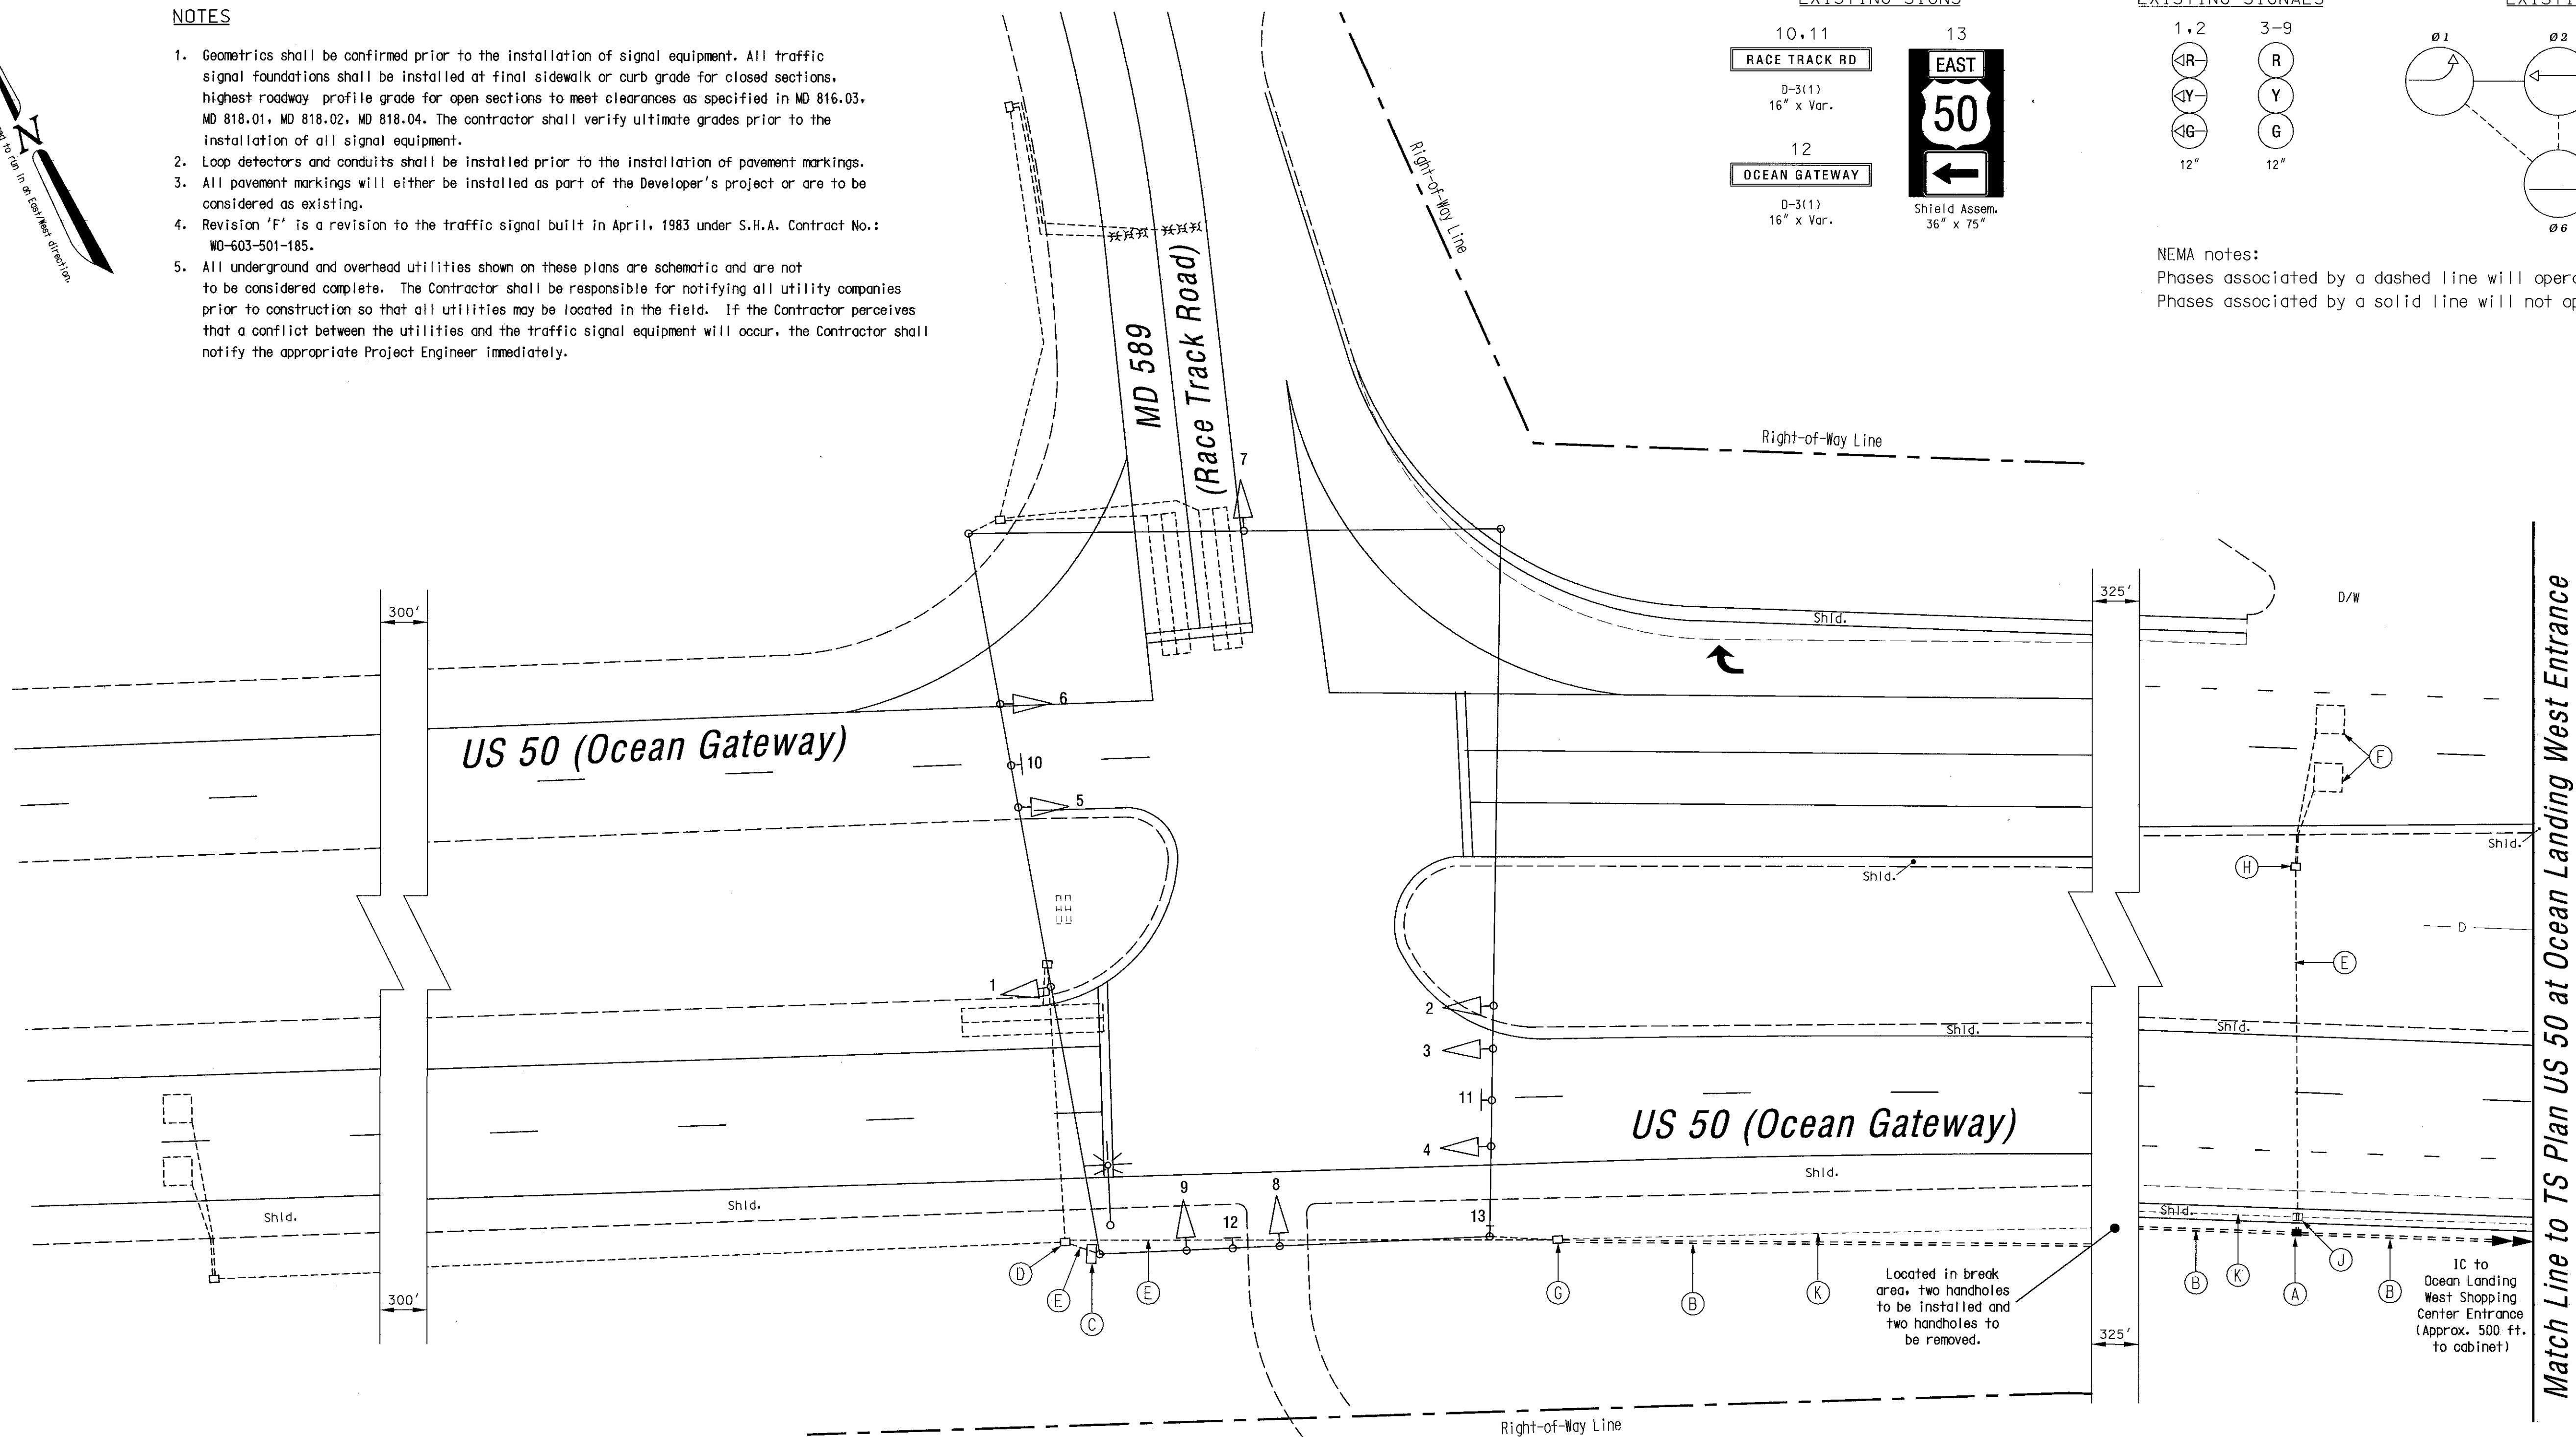

CONSTRUCTION DETAILS

- A. Install handhole.
- B. Install 2 in. polyvinyl chloride [Schedule 80] electrical conduit - trenched.
- C. Use existing cabinet/controller.
- D. Use existing handhole.
- E. Use existing conduit.
- F. Use existing loop detector.
- G. Use existing hanhole. Pull back existing Interconnect cable from Ocean Landing East Entrance (Wal-Mart) intersection, and run in new conduit back to new cabinet/controller located at the Ocean Landing West Entrance intersection.
- H. Use existing handhole, splice new 2-conductor aluminum shielded cable to existing loop detectors.
- J. Remove existing handhole, and extend 2 in. conduit.
- K. Cap and abandon existing conduit.

GEOMETRIC LEGEND

EXISTING GEOMETRICS
PROPOSED GEOMETRICS

UTILITY LEGEND

GAS MAIN
WATER MAIN
SEWER MAIN
ELECTRIC CABLES
STORM DRAIN
AERIAL CABLES
TELEPHONE CABLES



REVISIONS					APPROVALS	
E) Install Interconnect, March, 3, 2004 Modifications due to new geometrics. S.H.A. No.: BW996M82 IC to Ocean Landing West Entrance (Approx. 500 ft. to cabinet)					TEAM LEADER, TRAFFIC ENGINEERING DESIGN DIVISION	
D) 052003 - AS BUILT: INSTALL OPTICOM FOR E/B & W/B US 50 S.H.A. NO. AT2855185					ASST. CHIEF TRAFFIC ENGINEERING DESIGN DIVISION	
W/H	DJD	DAL	BRK	TH	CHIEF, TRAFFIC ENGINEERING DESIGN DIVISION	
C) Exclusive left turn to E/B US 50. S.H.A. No.: 2385512507301					DIRECTOR, TRAFFIC & SAFETY	
W/H	DJD	DAL	BRK	TH		
B) Recut side street loop detector. S.H.A. NO. 603-501-185						
SR	DAZ	ETP		TH		



MARYLAND DOT - STATE HIGHWAY ADMINISTRATION
Office of Traffic & Safety
TRAFFIC ENGINEERING DESIGN DIVISION
(Traffic Signal Plan)

US 50 (Ocean Gateway) at MD 589 (Race Track Road)

DRAWN BY: Schmid	F.A.P. NO. N/A	TS NO. 375E	SHEET NO. 1 OF 6
CHECKED BY:	S.H.A. NO. WO-603-501-185	T.I.M.S. NO. G-190	
SCALE: 1" = 20'	COUNTY: Worcester		
DATE: 04/08/83	LOG MILE: 23005009.64		